




TYPICAL 45° PARKING DIMENSIONS
STA 10+25.00 TO 12+50.00

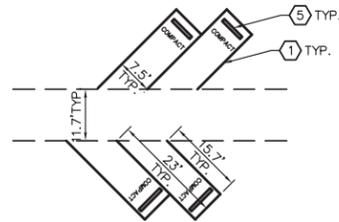


TYPICAL 40° COMPACT PARKING DIMENSIONS
STA 12+50.00 TO 14+40.00

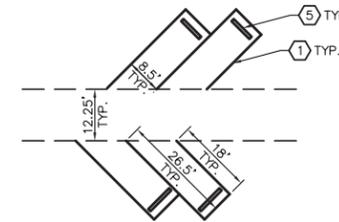

TYPICAL 45° PARKING DIMENSIONS
STA 14+40.00 TO 17+29.00

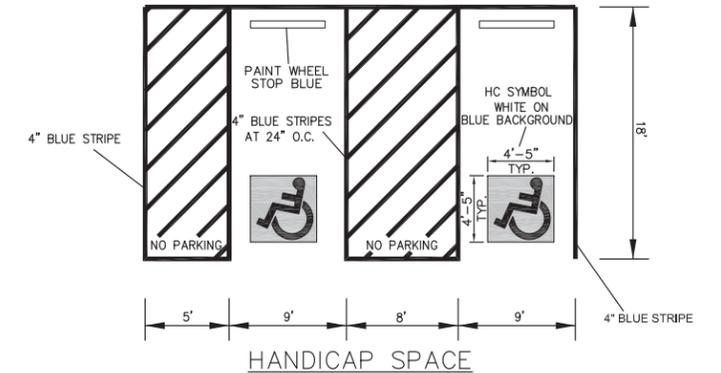

HANDICAP SPACE

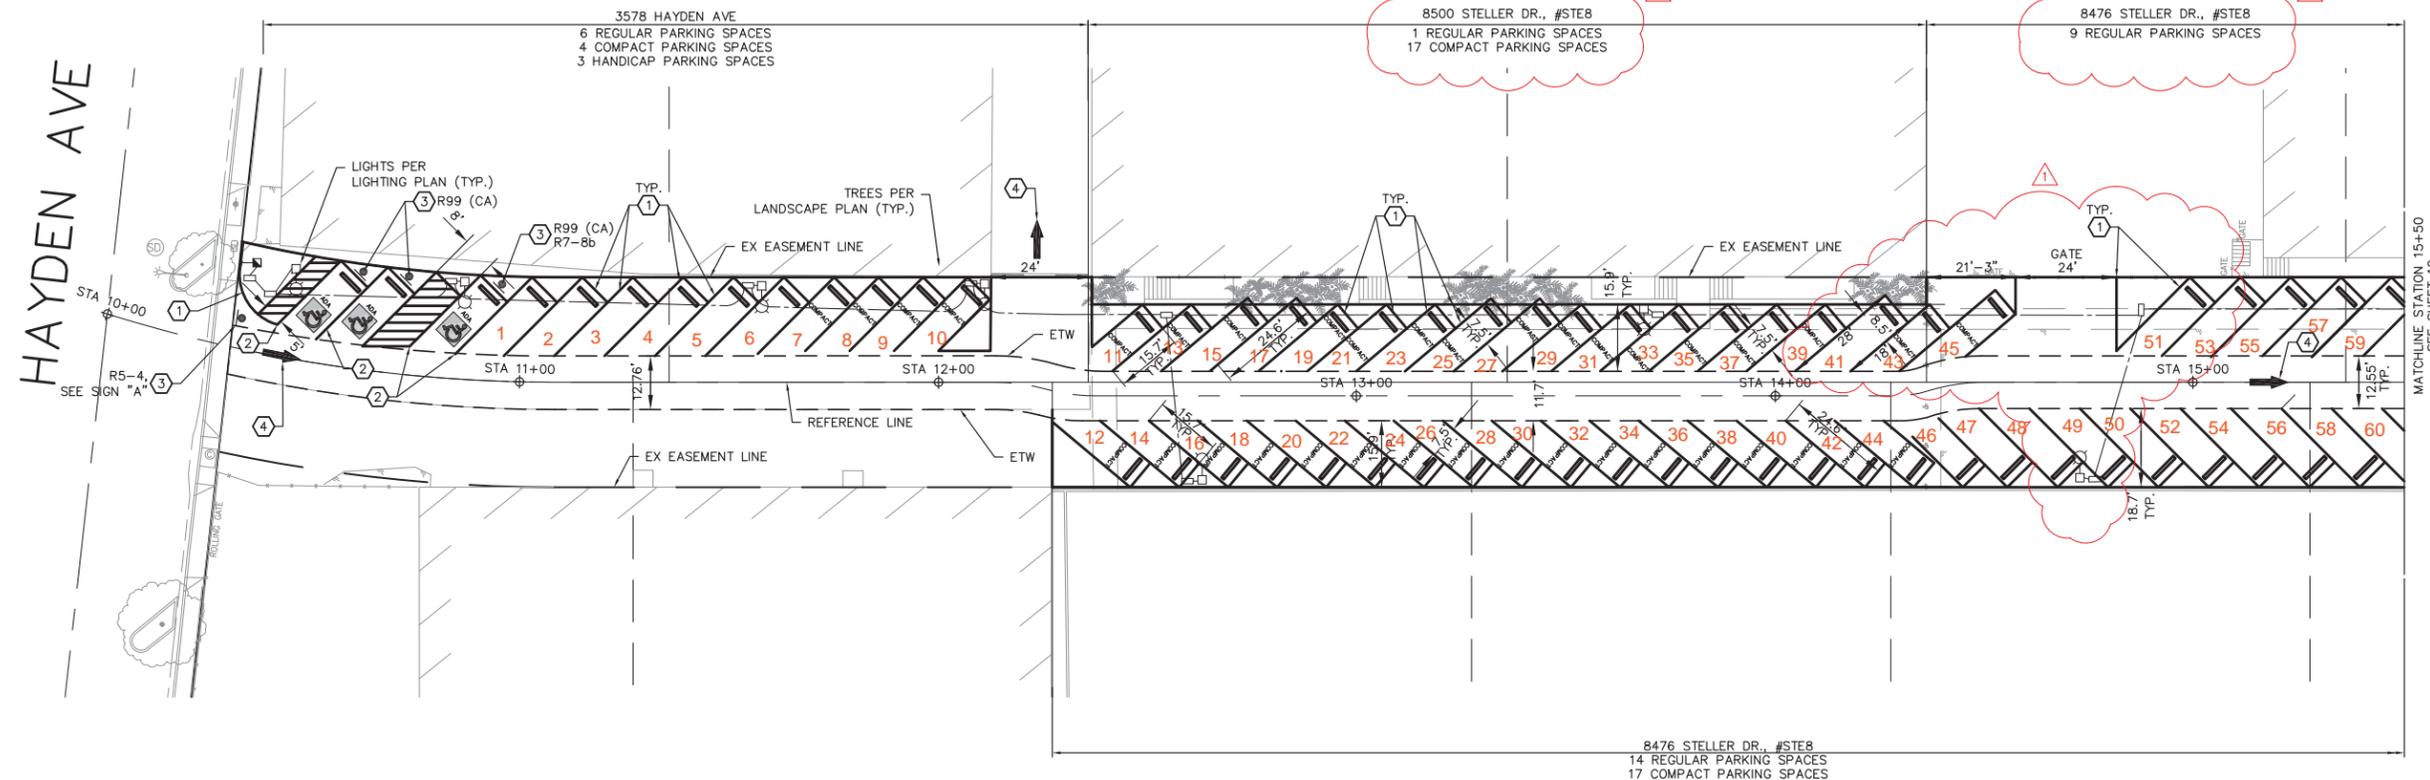

SIGNING AND STRIPING NOTES

- ① INSTALL 4" SOLID WHITE STRIPE PER STANDARD PARKING DETAILS. CONTRACTOR TO INSTALL CAT TRACKING FOR APPROVAL 48 HOURS PRIOR TO STRIPING.
- ② INSTALL HANDICAP SPACE STRIPING AND MARKING PER HANDICAP SPACE DETAIL
- ③ INSTALL NEW SIGN AND POST AS SHOWN ON PLANS
- ④ INSTALL PAVEMENT MARKINGS AS SHOWN ON PLANS, COLOR WHITE
- ⑤ INSTALL CONCRETE WHEEL STOP PER WHEEL STOP DETAIL.
- ⑥ INSTALL 4" WHITE DIAGONAL STRIPE AT 5' O.C.
- ⑦ 12" SOLID WHITE LIMIT LINE PER CALTRANS STD. PLANS, PLAN NO. A24E.

NOTE:
ALL STRIPINGS AND MARKINGS TO BE TWO COATS PAINT WITH REFLECTIVE BEADS.

SIGN LEGEND

UNAUTHORIZED VEHICLES NOT DISPLAYING IDENTIFYING PLACARDS OR LICENSE PLATES ISSUED FOR DISABLED PERSONS WILL BE TOWED AWAY AT OWNERS EXPENSE.
TOWED VEHICLES MAY BE RECOVERED AT (CITY TO SPECIFY) OR BY TELEPHONE (CITY TO SPECIFY)


R100B (CA)

PARKING ONLY
R99 (CA)


NO COMMERCIAL VEHICLES
R5-4

NO VEHICLES OVER 20 FEET
SIGN "A"

VAN ACCESSIBLE
R7-8b

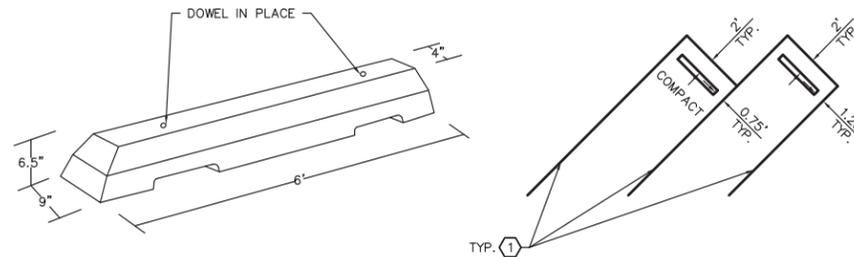

WHEEL STOP DETAIL

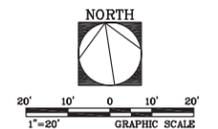

KOA CORPORATION
PLANNING & ENGINEERING
3190 C. SHELBY STREET
ONTARIO, CALIFORNIA 91764
Tel: (909) 890-9693 Fax: (909) 890-9694

REGISTERED PROFESSIONAL ENGINEER
No. 50481
Exp. 6-30-17
STATE OF CALIFORNIA

KOA PROJECT JB46142

△	STRIPING MODIFICATION				
△					
△					
NO.	REVISION	BY	APPR.	DATE	PROJECT NUMBER


CITY OF CULVER CITY
COMMUNITY DEVELOPMENT DEPARTMENT
ECONOMIC DEVELOPMENT DIVISION
CULVER CITY, CALIFORNIA

HAYDEN TRACT OWNERS ASSOCIATION
PARKING IMPROVEMENT PROJECT
STRIPING PLAN


APPROVED BY: CHARLES D. HERBERTSON
CITY ENGINEER RCE 46658 DATE

Drawing No.
Sheet 8 Of 9 Sheets


PERMIT/PLAN CHECK NO. B16-0289

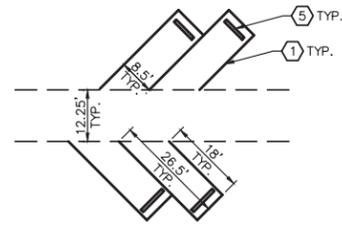


TYPICAL 45° PARKING DIMENSIONS
STA 14+40.00 TO 17+29.00

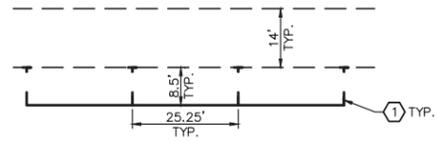


TYPICAL PARKING DIMENSIONS
STA 17+29.00 TO 18+31.42

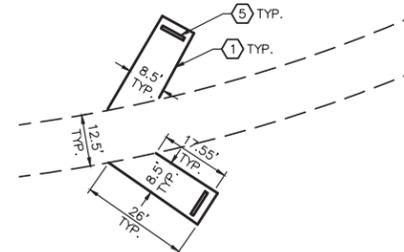

TYPICAL 45° PARKING DIMENSIONS
STA 18+31.42 TO 20+50.00

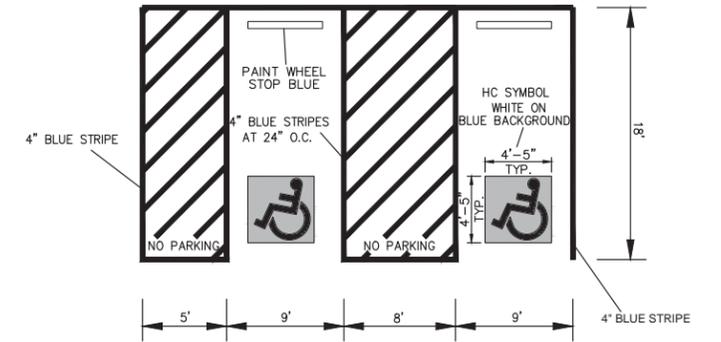

HANDICAP SPACE

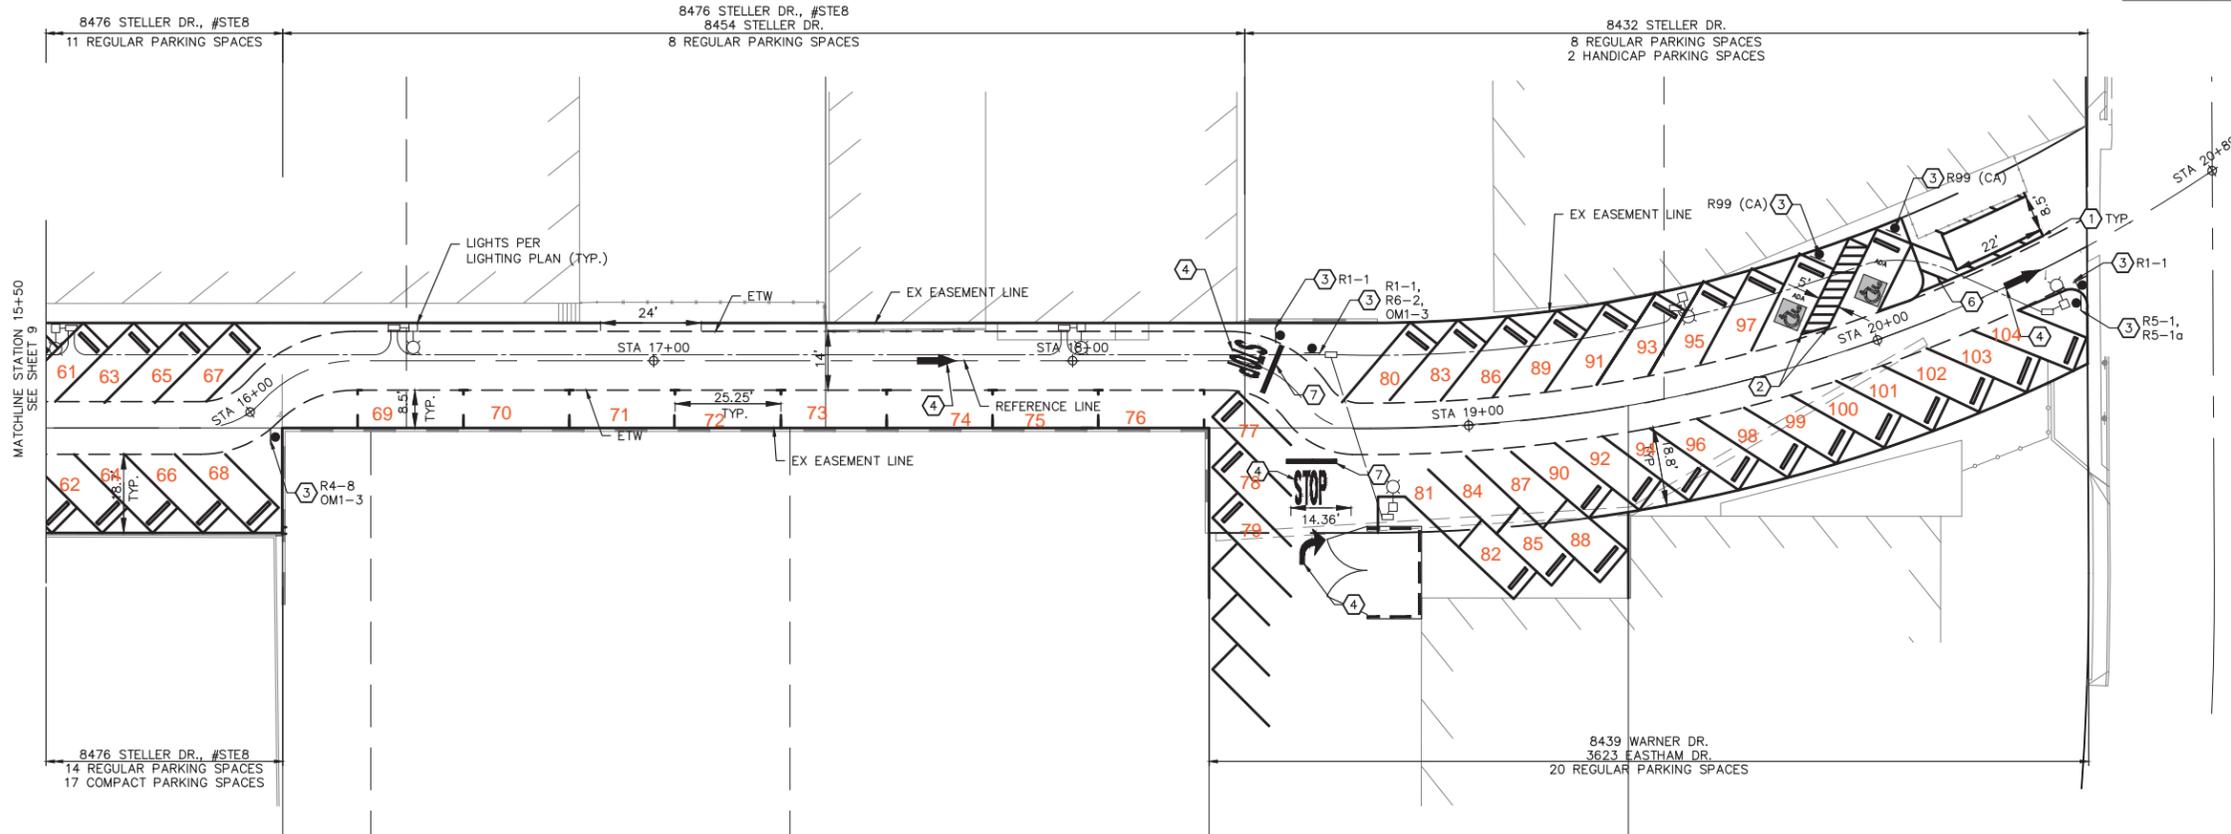


EASTHAM DRIVE

SIGNING AND STRIPING NOTES


- 1 INSTALL 4" SOLID WHITE STRIPE PER STANDARD PARKING DETAILS. CONTRACTOR TO INSTALL CAT TRACKING FOR APPROVAL 48 HOURS PRIOR TO STRIPING.
- 2 INSTALL HANDICAP SPACE STRIPING AND MARKING PER HANDICAP SPACE DETAIL
- 3 INSTALL NEW SIGN AND POST AS SHOWN ON PLANS
- 4 INSTALL PAVEMENT MARKINGS AS SHOWN ON PLANS, COLOR WHITE
- 5 INSTALL CONCRETE WHEEL STOP PER WHEEL STOP DETAIL.
- 6 INSTALL 4" WHITE DIAGONAL STRIPE AT 5' O.C.
- 7 12" SOLID WHITE LIMIT LINE PER CALTRANS STD. PLANS, PLAN NO. A24E.

NOTE:
ALL STRIPINGS AND MARKINGS TO BE TWO COATS PAINT WITH REFLECTIVE BEADS.

SIGN LEGEND

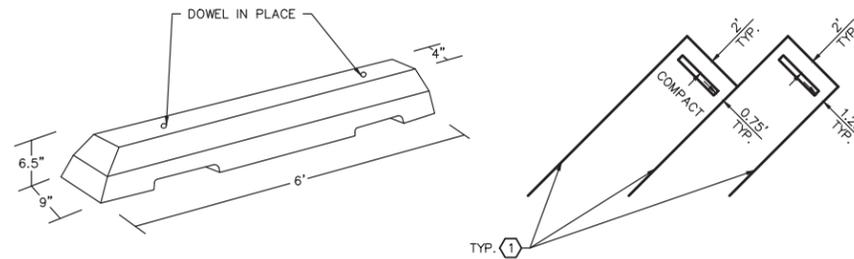

WHEEL STOP DETAIL

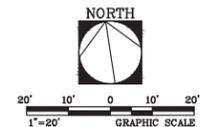

PERMIT/PLAN CHECK NO. B16-0289

CITY OF CULVER CITY
COMMUNITY DEVELOPMENT DEPARTMENT
ECONOMIC DEVELOPMENT DIVISION
CULVER CITY, CALIFORNIA

HAYDEN TRACT OWNERS ASSOCIATION
PARKING IMPROVEMENT PROJECT
STRIPING PLAN

APPROVED BY: CHARLES D. HERBERTSON
CITY ENGINEER RCF 46658 DATE _____
Drawing No. _____
Sheet 9 Of 9 Sheets



KOA CORPORATION
PLANNING & ENGINEERING
3190 C. SHELBY STREET
ONTARIO, CALIFORNIA 91764
Tel: (909) 890-9693 Fax: (909) 890-9694

NO.	REVISION	BY	APPR.	DATE	PROJECT NUMBER

KOA PROJECT JB46142