

Attachment No. 8



FIRST PROPOSED BUILDING



REVISED PROPOSED BUILDING

THE USE OF THESE PLANS AND SPECIFICATIONS SHALL BE RESTRICTED TO THE ORIGINAL SITE FOR WHICH THEY WERE PREPARED AND PUBLICATION THEREOF IS EXPRESSLY LIMITED TO SUCH USE. REUSE, REPRODUCTION OR PUBLICATION BY ANY METHOD, IN WHOLE OR IN PART IS PROHIBITED. TITLE TO THE PLANS AND SPECIFICATIONS REMAINS WITH THE ARCHITECT. WITHOUT PREJUDICE VISUAL CONTACT WITH THESE DOCUMENTS SHALL CONSTITUTE PRIMA FACIE EVIDENCE OF THESE RESTRICTIONS

SUBMITTAL DATES:	
OWNER:	
PLAN CHECK:	
O.T.B.:	

1	2	3	4
NO.	NO.	NO.	NO.
DATE	DATE	DATE	DATE

PROCESS SHEET

SHEET TITLE: ARCHITECT: FARZIN MALY 6524 BALBOA BLVD. LAKE BALBOA, CA, 91406 Ph: 818. 770. 0161 Email: farzin.maly@gmail.com	OWNER AND PROJECT ADDRESS: 11281 WASHINGTON PLACE LLC. 11281 WASHINGTON PL CULVER CITY, CA.90230
---	---

JOB NO:	
DATE:	01.28.17
DRAWN BY:	F. M.
APPROVED BY:	

SHEET NO:

A-21




FIRST PROPOSED BUILDING
SOUTH ELEVATION



REVISED PROPOSED BUILDING
SOUTH ELEVATION



FIRST PROPOSED BUILDING
WEST ELEVATION

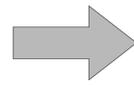

REVISED PROPOSED BUILDING
WEST ELEVATION

THE USE OF THESE PLANS AND SPECIFICATIONS SHALL BE RESTRICTED TO THE ORIGINAL SITE FOR WHICH THEY WERE PREPARED AND PUBLICATION THEREOF IS EXPRESSLY LIMITED TO SUCH USE. REUSE, REPRODUCTION OR PUBLICATION BY ANY METHOD, IN WHOLE OR IN PART IS PROHIBITED. TITLE TO THE PLANS AND SPECIFICATIONS REMAINS WITH THE ARCHITECT. WITHOUT PREJUDICE VISUAL CONTACT WITH THESE DOCUMENTS SHALL CONSTITUTE PRIMA FACIE EVIDENCE OF THE ACCEPTANCE OF THESE RESTRICTIONS

	4	5	6			
R E V I S I O N S	1	2	3	NO.	DATE	DATE

SUBMITTAL DATES:

OWNER: _____

PLAN CHECK: _____

O.T.B. _____

OWNER AND PROJECT ADDRESS:
11281 WASHINGTON PLACE LLC.
11281 WASHINGTON PL
CULVER CITY, CA 90230

SHEET TITLE: **PROCESS SHEET**

ARCHITECT:
FARZIN MALY
6524 BALBOA BLVD.
LAKE BALBOA, CA, 91406
Ph: 818. 770. 0161
Email: farzin.maly@gmail.com

STAMP

LICENSED ARCHITECT

FARZIN MALY

NO. C-33731

05-31-17

RENEWAL DATE

STATE OF CALIFORNIA

JOB NO: _____

DATE: 01.28.17



DRAWN BY: F. M.

APPROVED BY: _____


SHEET NO: **A-22**




FIRST PROPOSED BUILDING
NORTH ELEVATION

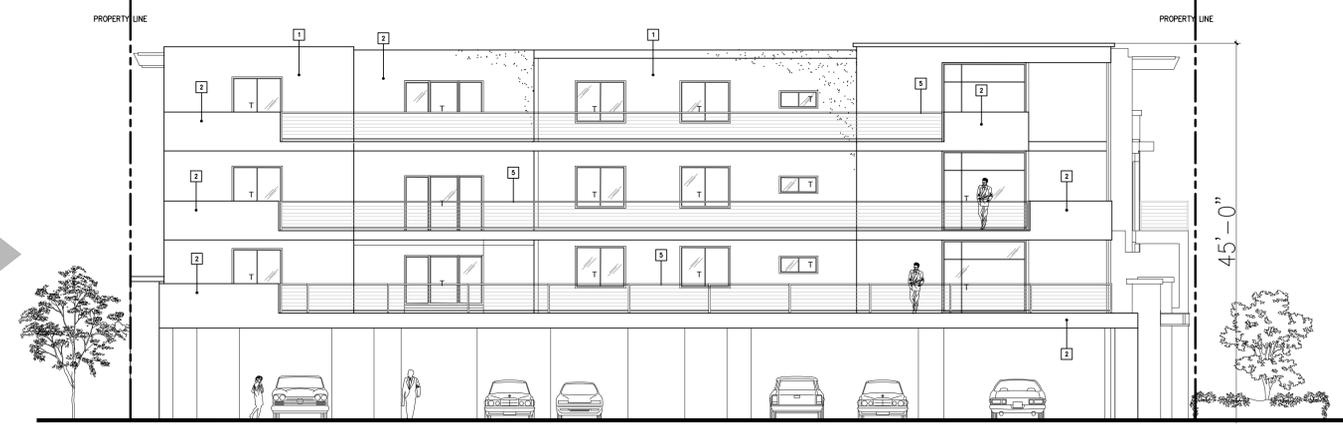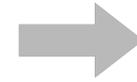

REVISED PROPOSED BUILDING
NORTH ELEVATION

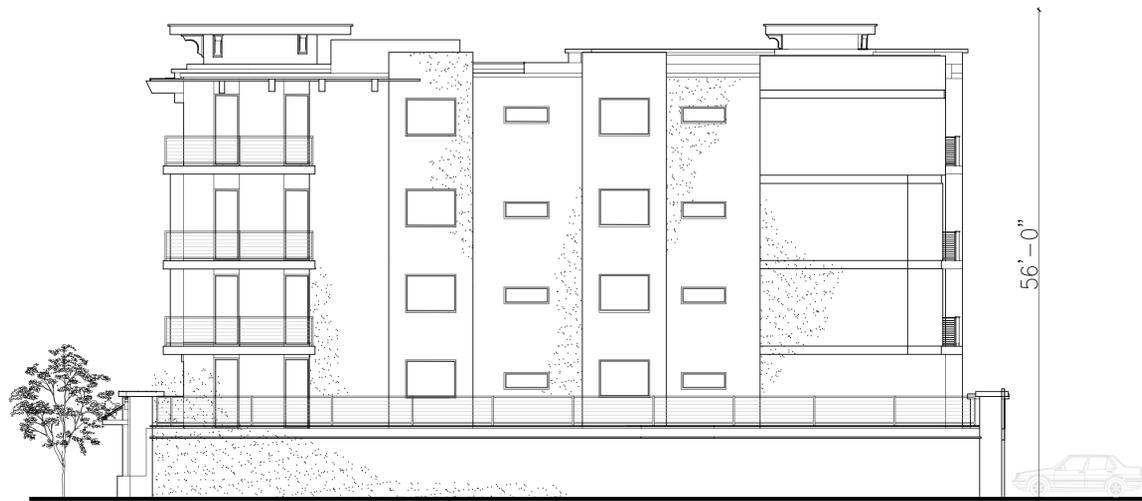

FIRST PROPOSED BUILDING
EAST ELEVATION

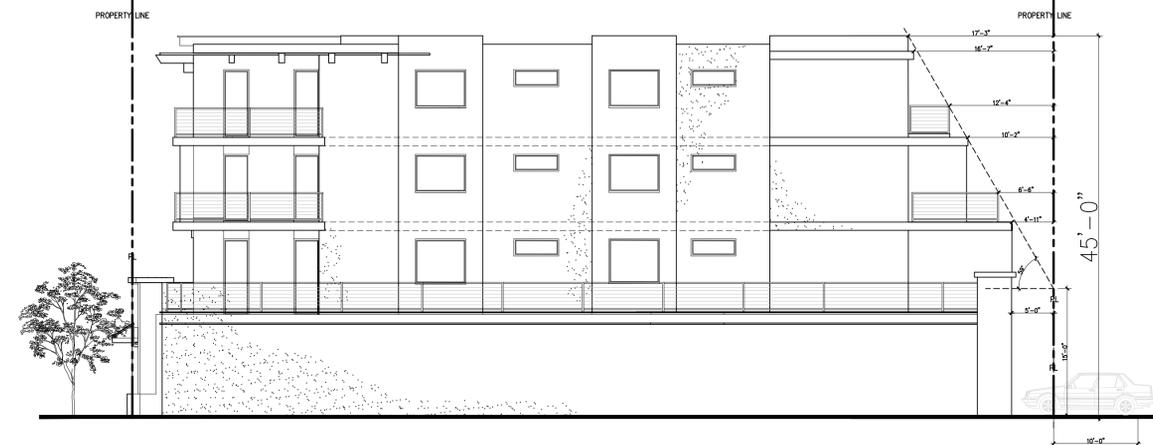

REVISED PROPOSED BUILDING
EAST ELEVATION

THE USE OF THESE PLANS AND SPECIFICATIONS SHALL BE RESTRICTED TO THE ORIGINAL SITE FOR WHICH THEY WERE PREPARED AND PUBLICATION THEREOF IS EXPRESSLY LIMITED TO SUCH USE. REUSE, REPRODUCTION OR PUBLICATION BY ANY METHOD, IN WHOLE OR IN PART IS PROHIBITED. TITLE TO THE PLANS AND SPECIFICATIONS REMAINS WITH THE ARCHITECT. WITHOUT PREJUDICE VISUAL CONTACT WITH THESE DOCUMENTS SHALL CONSTITUTE PRIMA FACIE EVIDENCE OF THE ACCEPTANCE OF THESE RESTRICTIONS

REVISIONS	NO.	DATE
1		
2		
3		
4		
5		
6		

SUBMITTAL DATES:	OWNER:	PLAN CHECK:	O.T.B.:

OWNER AND PROJECT ADDRESS:
11281 WASHINGTON PLACE LLC.
 11281 WASHINGTON PL
 CULVER CITY, CA 90230

SHEET TITLE: **PROCESS SHEET**
 ARCHITECT:
FARZIN MALY
 6524 BALBOA BLVD.
 LAKE BALBOA, CA, 91406
 Ph: 818. 770. 0161
 Email: farzin.maly@gmail.com



JOB NO:
 DATE: 01.28.17
 DRAWN BY: F. M.
 APPROVED BY:

SHEET NO:
A-23