


Attachment No. 8



FIRST PROPOSED BUILDING

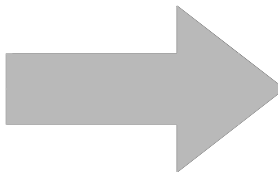

REVISED PROPOSED BUILDING

THE USE OF THESE PLANS AND SPECIFICATIONS SHALL BE RESTRICTED TO THE ORIGINAL SITE FOR WHICH THEY WERE PREPARED AND PUBLICATION THEREOF IS EXPRESSLY LIMITED TO SUCH USE. REUSE, REPRODUCTION OR PUBLICATION BY ANY METHOD, IN WHOLE OR IN PART IS PROHIBITED. TITLE TO THE PLANS AND SPECIFICATIONS REMAINS WITH THE ARCHITECT. WITHOUT PREJUDICE VISUAL CONTACT WITH THESE DOCUMENTS SHALL CONSTITUTE PRIMA FACIE EVIDENCE OF THESE RESTRICTIONS

REVISIONS

1	4
2	5
3	6
NO.	NO.
DATE	DATE

SUBMITTAL DATES:

OWNER:	
PLAN CHECK:	
O.T.B.	

SHEET TITLE:

PROCESS SHEET

ARCHITECT:

FARZIN MALY

6524 BALBOA BLVD.

LAKE BALBOA, CA. 91406

Ph: 818. 770. 0161

Email: farzin.maly@gmail.com

OWNER AND PROJECT ADDRESS:

11281 WASHINGTON PLACE LLC.

11281 WASHINGTON PL

CULVER CITY , CA.90230

STAMP

LICENSED ARCHITECT

FARZIN MALY

NO. C-33751

05-31-17

RENEWAL DATE

STATE OF CALIFORNIA

JOB NO:

DATE:

01.28.17


DRAWN BY:

F. M.

APPROVED BY:

SHEET NO:

A-21

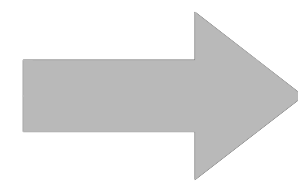

PROPERTY LINE

11281
Washington pl.

45'-0"





REVISED PROPOSED BUILDING
WEST ELEVATION


A-22





FIRST PROPOSED BUILDING
NORTH ELEVATION

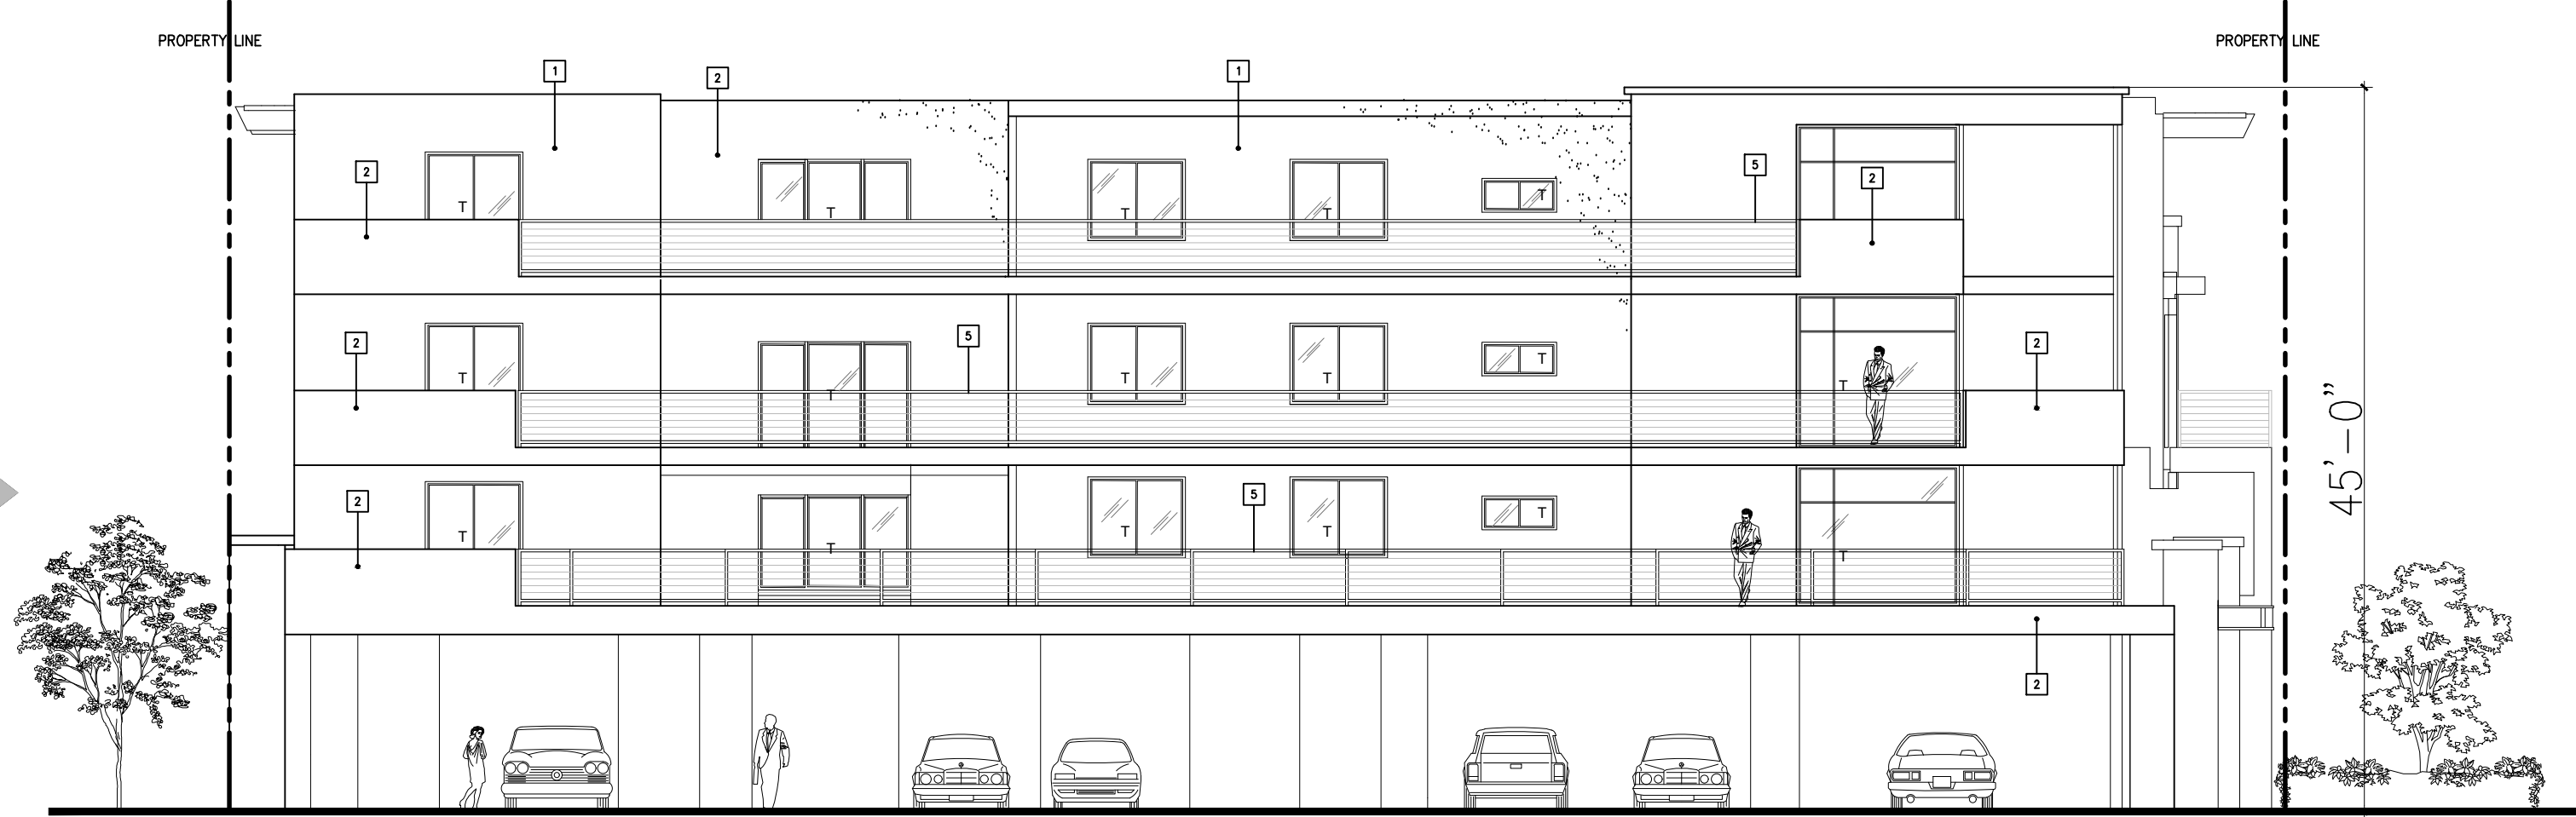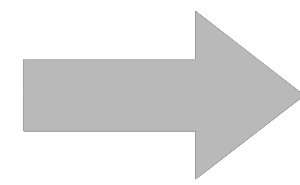

REVISED PROPOSED BUILDING
NORTH ELEVATION

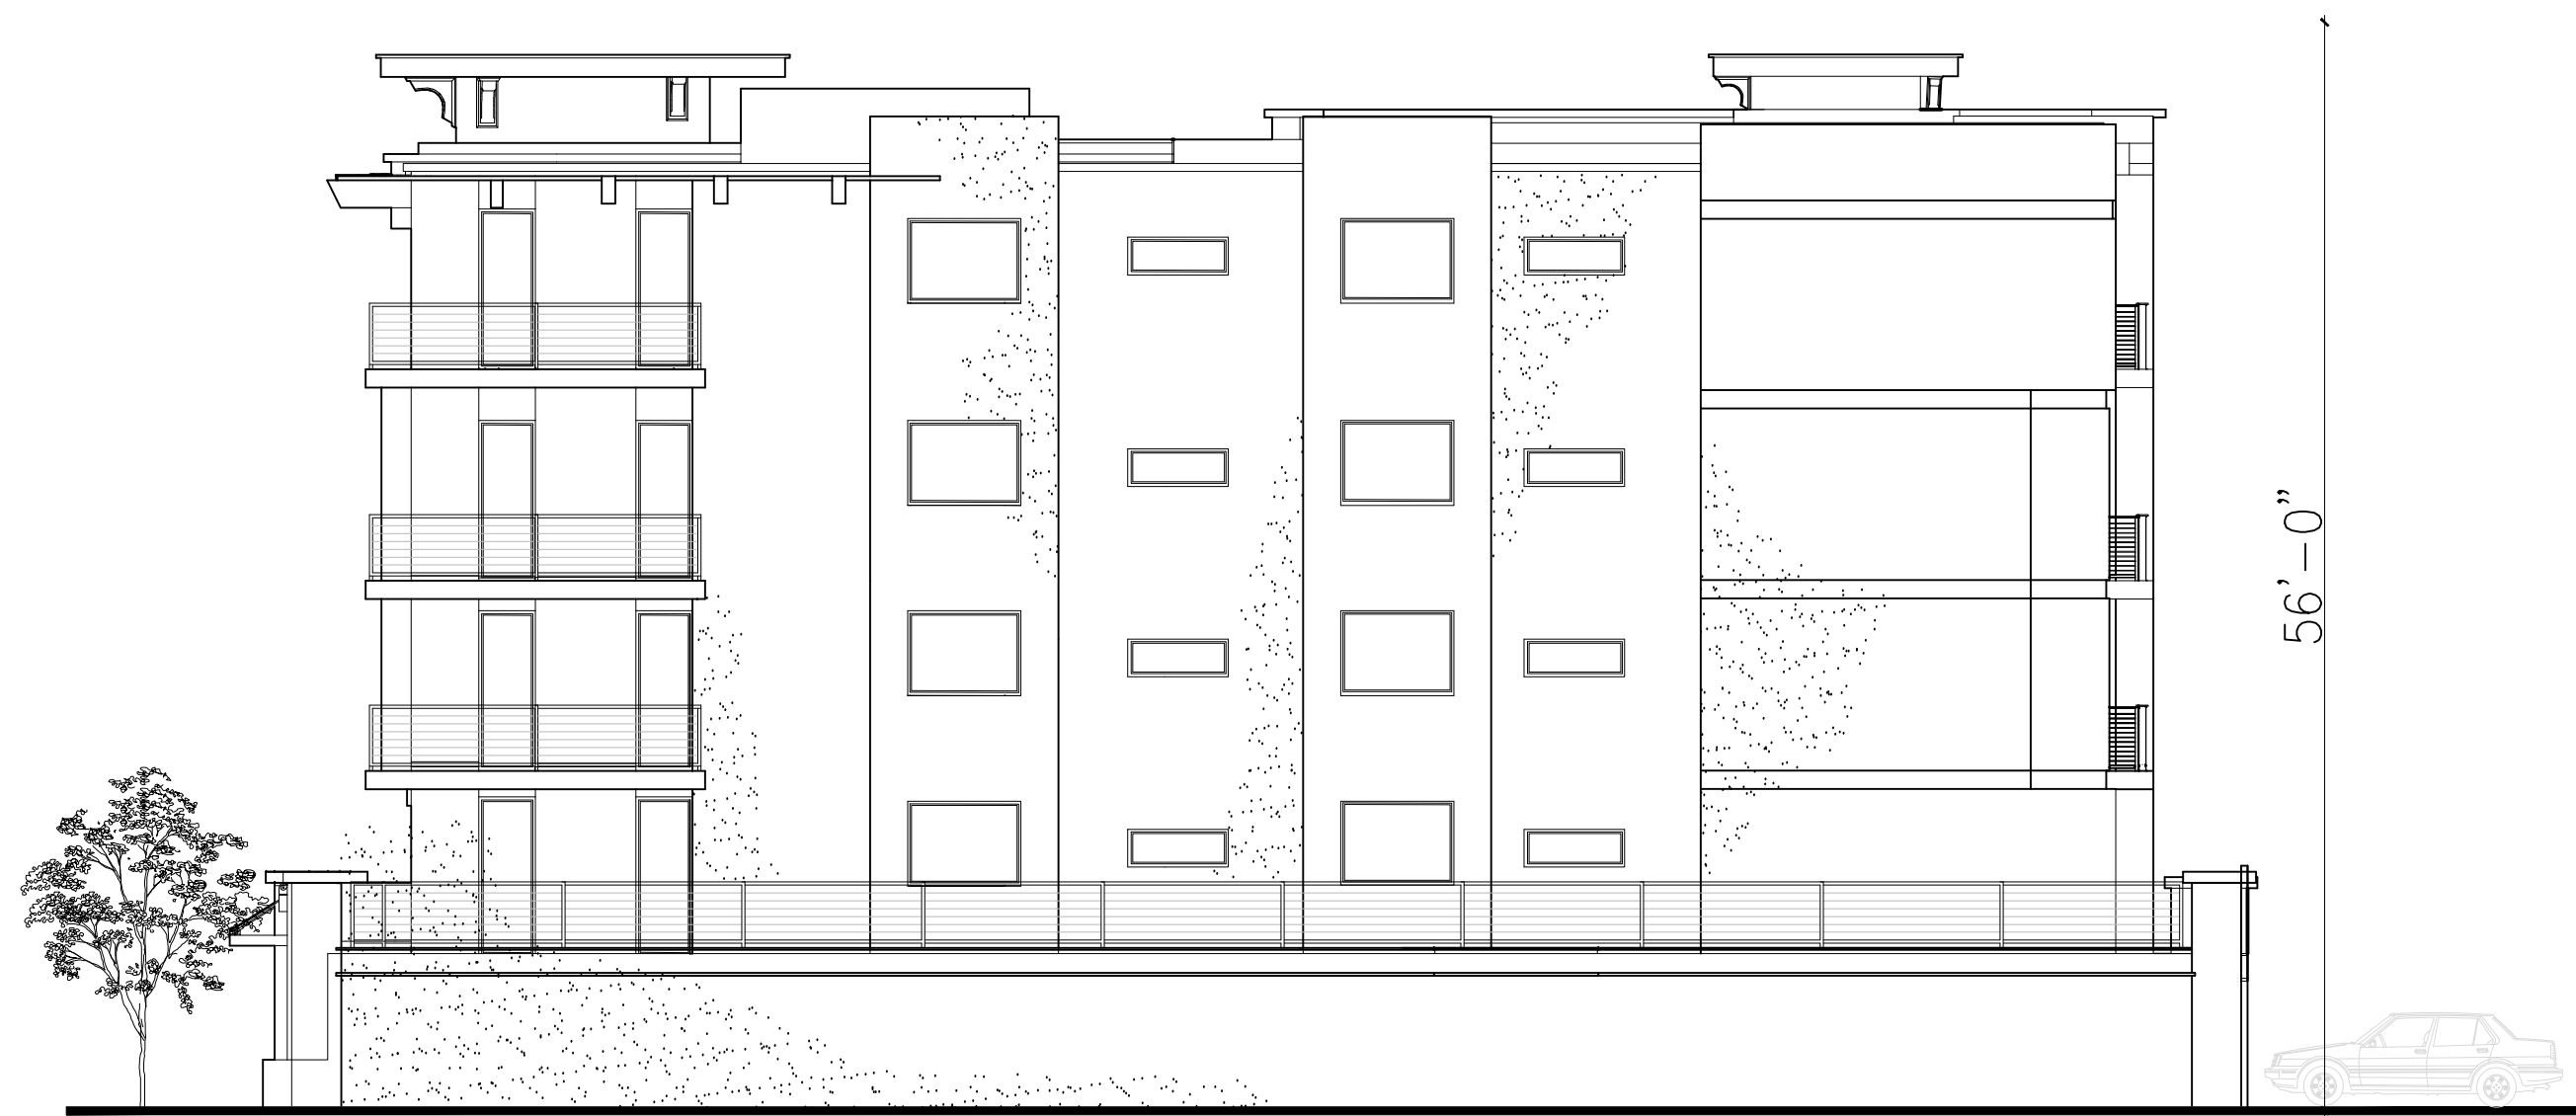

FIRST PROPOSED BUILDING
EAST ELEVATION

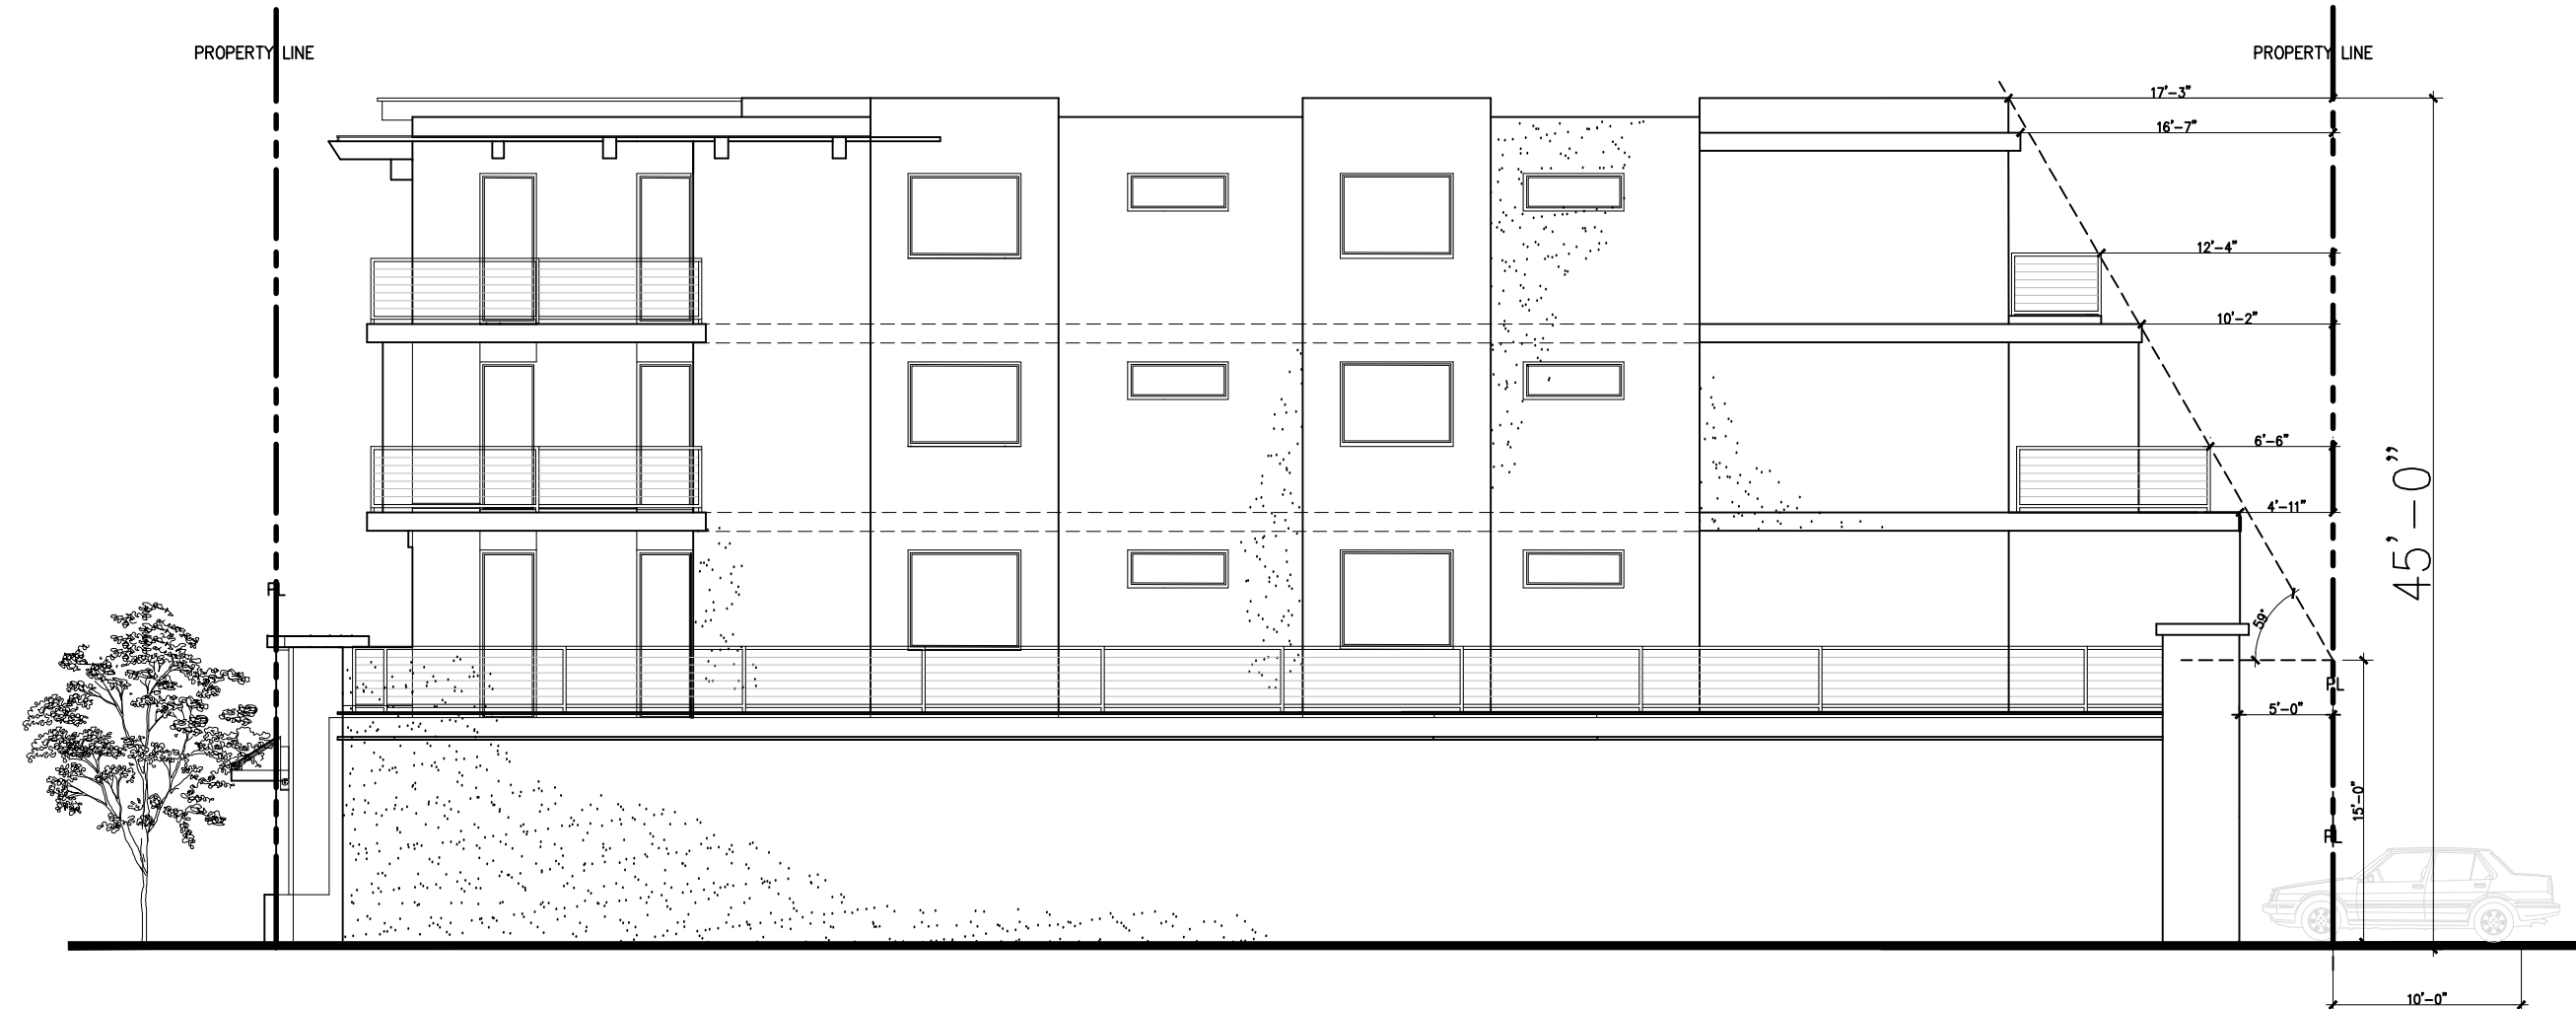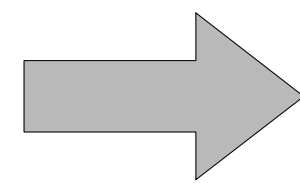

REVISED PROPOSED BUILDING
EAST ELEVATION


THE USE OF THESE PLANS AND SPECIFICATIONS SHALL BE RESTRICTED TO THE ORIGINAL SITE FOR WHICH THEY WERE PREPARED AND PUBLICATION THEREOF IS EXPRESSLY LIMITED TO SUCH USE. REUSE, REPRODUCTION OR PUBLICATION BY ANY METHOD, IN WHOLE OR IN PART IS PROHIBITED. TITLE TO THE PLANS AND SPECIFICATIONS REMAINS WITH THE ARCHITECT. WITHOUT PREJUDICE VISUAL CONTACT WITH THESE DOCUMENTS SHALL CONSTITUTE PRIMA FACIE EVIDENCE OF THESE RESTRICTIONS

SUBMITTAL DATES:			REVISIONS		
NO.	DATE	NO.	NO.	DATE	NO.
1		2	4		
3		5			
		6			

OWNER:	PLAN CHECK:	O.T.B.

OWNER AND PROJECT ADDRESS:	11281 WASHINGTON PLACE LLC.
	11281 WASHINGTON PL
	CULVER CITY , CA 90230

SHEET TITLE:	PROCESS SHEET
ARCHITECT:	FARZIN MALY
	6524 BALBOA BLVD.
	LAKE BALBOA, CA. 91406
	Ph: 818. 770. 0161
	Email: farzin.maly@gmail.com

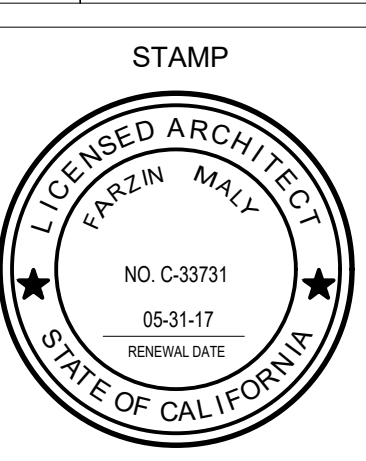

JOB NO:	
DATE:	01.28.17
DRAWN BY:	F. M.
APPROVED BY:	

SHEET NO:	A-23
-----------	------